


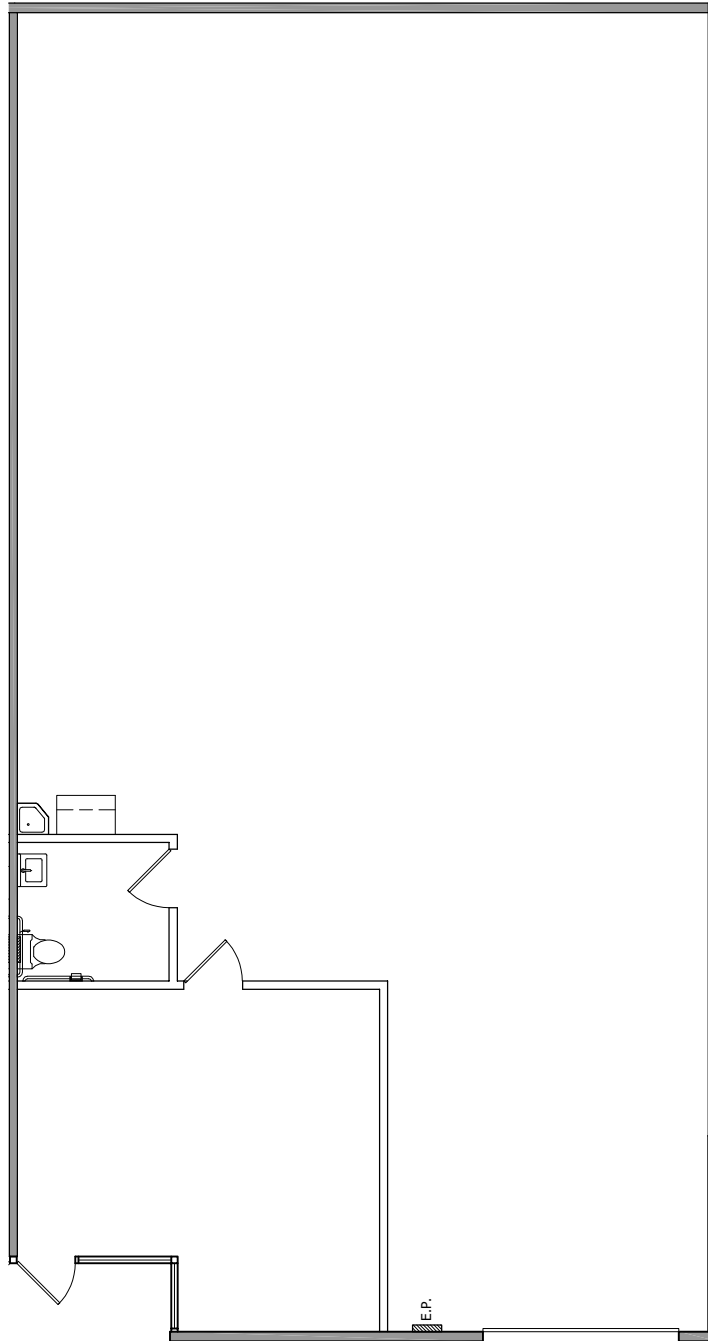

SCALE: 3/32"=1'-0"

CDL
DESIGN

INTERIOR ARCHITECTURE + SPACE PLANNING

12 MAUCHLY, SUITE E | CDLDESIGNGROUP.COM
IRVINE, CA 92618 | P: 949.679.6456

AS-BUILT

CDL DESIGN GROUP MAKES EVERY REASONABLE EFFORT TO ENSURE THE ACCURACY OF THE INFORMATION PROVIDED ON THIS AS-BUILT PLAN. THIS PLAN IS INTENDED ONLY TO PROVIDE A SCALED GRAPHIC REPRESENTATION OF OBSERVABLE EXISTING CONDITIONS BASED ON LIMITED FIELD MEASUREMENTS, AND MAY NOT REFLECT ALL EXISTING OR CONCEALED CONDITIONS. THIS DRAWING IS NOT INTENDED TO SERVE AS A SUBSTITUTE FOR SITE VERIFICATION, ENGINEERING ANALYSIS OR CODE COMPLIANCE REVIEW AND ITS USE WILL BE AT USER'S SOLE RISK AND WITHOUT LIABILITY OR LEGAL EXPOSURE TO CDL DESIGN GROUP.

SUITE D

MOUNTAIN VIEW BUSINESS PARK
1440 ARROW HWY.
IRVINDALE, CA.
±2,439 SQ. FT.